

Holiday Park Multigenerational Center


Project No: 588102

City of Albuquerque

Department of Municipal Development
Albuquerque, New Mexico



MARCH 1, 2013
RECORD SET

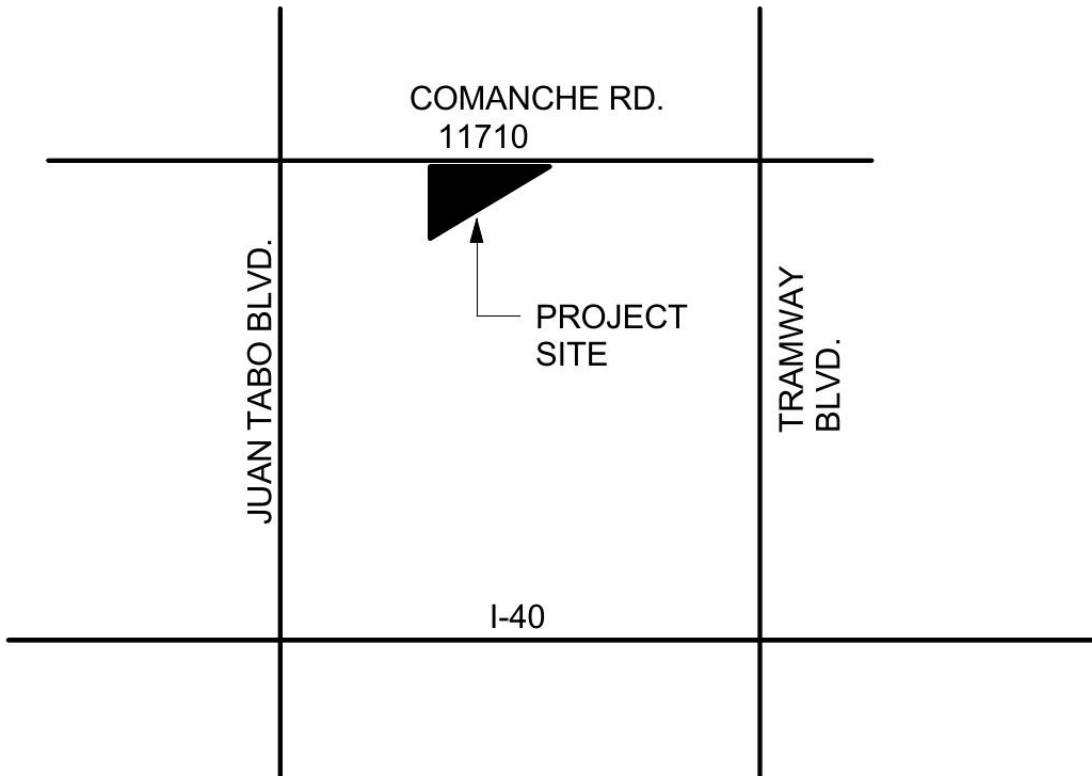

Vicinity Map
G-22-Z
NORTH

Richard J. Berry, Mayor

City Council

Don Harris, President, District 9
Rey Garduno, Vice President, District 6
Ken Sanchez, District 1
Debbie O'Malley, District 2
Isaac Benton, District 3
Brad Winter, District 4
Dan Lewis, District 5
Trudy Jones, District 8

Administration Officials


Robert J. Perry, Chief Administrative Officer
Amy B. Bailey, City Clerk
Michael J. Riordan, P.E., Director, Municipal Development
Barbara L. Taylor, Project Manager

Sheet Number	Sheet Name	Sheet Number	Sheet Name	Sheet Number	Sheet Name	Sheet Number	Sheet Name	Sheet Number	Sheet Name
GENERAL		STRUCTURAL		A313	Wall Sections	MECHANICAL/PLUMBING		ELECTRICAL	
G001	Cover Sheet	S001	General Notes	A314	Wall Sections	M001	HVAC Legend	E001	Electrical Legend
A001	General Notes	S002	General Notes and Abbreviations	A315	Wall Sections	MH101	Mechanical HVAC Floor Plan	ES101	Electrical Site Plan
A002	Code Plan	S003	Schedule of Structural Tests and Special Inspections	A316	Wall Sections	MH120	Mechanical Roof Plan	EL101	Electrical Lighting Floor Plan
A003	Typical Accessibility Details / Suspended Ceiling Notes	S101	Foundation / Floor Plan Base Bid	A317	Wall Sections	M501	HVAC Detail	EP101	Electrical Power Floor Plan
		S102	Low Roof Framing Plan - Base Bid	A318	Wall Sections	M502	HVAC Detail	EP120	Electrical Roof Plan
		S103	High Roof Framing Plan - Base Bid	A319	Wall Sections	MI001	HVAC Instrumentation Plan	ET101	Electrical Telecom Plan
ARCHITECTURAL SITE		S104	Structural Plans - Alternate	A320	Details	MI601	HVAC Diagrams (Controls)	E501	Electrical Detail Sheet
AS101	Site Plan	S201	Braced Frame Elevations	A321	Details	MI602	HVAC Diagram (Controls)	E601	Electrical Diagrams
AS401	Site Details	S202	Braced Frame Elevations	A322	Details	M701	HVAC Schedules	E602	Electrical Diagrams
AS402	Site Details	S301	Sections	A401	Enlarged Restroom Plans & Elevations	M900	Mechanical Additive Alternate	E701	Electrical Schedules
AS403	Enlarged Site Plans	S302	Sections	A402	Enlarged Plans and Elevations	P001	Plumbing Legend	E702	Electrical Panel Schedules
AS901	Add Alternate No. 2 Site Plan	S303	Sections	A403	Interior Elevations	PD100	Plumbing Demolition Plan	E900	Electrical Additive Alternates
		S501	Details	A404	Interior Details	FX101	Fire Protection Plan		
CIVIL		S701	Typical Details	A405	Reception Desk Details	PL101	Plumbing Waste & Vent Floor Plan		
CD100	Demolition Plan			A501	Roof Details	PL120	Plumbing Roof Plan		
C101	Grading and Drainage Plan	ARCHITECTURAL		A502	Typical Roof Details	PP101	Plumbing Piping Floor Plan		
C102	Preliminary Utility Plan	AD100	Architectural Demolition Plan	A510	Interior Details	P401	Plumbing Enlarged Plans		
C103	ABCWUA Mini Work Order	A101	Architectural Floor Plan	A601	Door Schedule	P501	Plumbing Details		
C901	Alternate Grading and Drainage Plan	A102	Dimension Plan	A602	Glazing Elevations	P701	Plumbing Specifications		
		A110	Reflected Ceiling Plan	A603	Glazing Elevations	P702	Plumbing Schedules		
LANDSCAPE		A120	Clerestory Roof Plan	A604	Glazing Elevations, Glazing/Door Details	P900	Plumbing Additive Alternates		
L-101	Landscape Plan General Notes	A121	Roof Plan	A605	Glazing Details				
LD-101	Demolition & Irrigation Reconfiguration Base Bid	A201	Building Elevations	A606	Glazing Details				
LI-901	Irrigation Plan Additive Alternate	A202	Planter Details & Building Elevations	A607	Glazing/Door Details				
LP-901	Landscape Plan Additive Alternate	A301	Building Sections	A608	Door Details				
		A310	Wall Sections	A610	Finish Schedule				
		A311	Wall Sections	A900	Additive Alternate No. 1 Plans and Elevations				
		A312	Wall Sections	A901	Additive Alternate Wall Sections				

RECORD DRAWING

This record drawing has been prepared, in part, based upon information furnished by others. While this information is believed to be reliable, the DESIGN PROFESSIONAL cannot assure its accuracy, and thus is not responsible for the accuracy of this record drawing or for any errors or omissions which may have been incorporated into it as a result. Those relying on this record document are advised to obtain independent verification of its accuracy before applying it for any purpose.

Kells + Craig

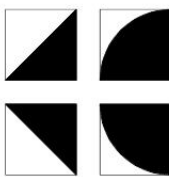

Architects, Inc. AIA • AIA • 400 GOLD SW, SUITE 880 • Albuquerque, New Mexico 87102 •

PROPERTY INFORMATION

City of Albuquerque 11710 Comanche Rd. NE

CONTACTS

Owner
City of Albuquerque
Department of Municipal Development
Barbara Taylor
Phone: (505) 768-3849
Fax: (505) 768-2310

Holiday Park Community Center
Dennis Sanchez
Phone: (505) 238-7950

Architect of Record
Kells + Craig Architects, Inc.
400 Gold St. SW, Suite 880
Albuquerque, New Mexico 87102
Phone: (505) 243-2724
Fax: (505) 842-5804
www.kellsandcraig.com

Structural Engineer
RME-ABQ
2835 Pan American Freeway NE
Albuquerque, New Mexico 87107

Mechanical & Electrical Engineers
Bridgers & Paxton
4600-C Montgomery NE
Albuquerque, New Mexico 87109
Phone: (505) 883-4111
Fax: (505) 888-1436

Civil Engineer
Scott M. McGee
9700 Tanoan Drive NE
Albuquerque, New Mexico 87111
Phone: (505) 263-2905

Geotechnical
Terracon
4905 Hawkins NE
Albuquerque, New Mexico 87109
(505)797-4287
(505)797-4288

Landscape Architect
Sites Southwest
124 Tiares Ave. NE

GENERAL NOTES

1. FIRE ALARM AND SPRINKLER SHOP DRAWINGS AND CALCULATIONS SHALL BE SUBMITTED TO FIRE MARSHAL FOR REVIEW AND APPROVAL.

REV.	SHEETS	CITY ENGINEER	DATE	USER DEPARTMENT	DATE				U
ARCHITECT STAMP & SIGNATURE		APPROVALS	ENGINEER		DATE	*	*		APPF
		DRC Chairman							
		Transportation							
		Water/Wastewater							
		Hydrology							
		Parks							
		Constr. Mngmt.							City E